



November 18, 2020

Via Electronic Mail Only

UPDATED Notice of Project Change for the Enbridge Gas Inc. St. Laurent Ottawa North Replacement Pipeline Project in the City of Ottawa, Ontario

Enbridge Gas Inc. (Enbridge Gas) retained Dillon Consulting Limited (Dillon) to undertake a route selection and environmental and socio-economic impact study and report (Environmental Report) for the proposed St. Laurent Ottawa North Replacement Pipeline Project (the Project). The Environmental Report was completed in late June 2020 according to the Ontario Energy Board (OEB) Environmental Guidelines for the Location, Construction, and Operation of Hydrocarbon Pipelines and Facilities in Ontario, 7th Edition (2016).

On July 21, 2020, the Environmental Report (June 2020) was posted to the Enbridge Gas project website and was submitted to the Ontario Pipeline Coordinating Committee (OPCC) for review. The 42-day OPCC review period ended on September 1, 2020.

On October 19 and 20, 2020, Enbridge Gas distributed a Notice of Project Change to the Project contact list for a new preferred route for Phase 4 of the pipeline, which was a hybrid of the existing preferred route and one of the alternative routes identified in the Environmental Report (June 2020).

Over the past month, through continued consultation with key stakeholders, Enbridge Gas has revised the new preferred route described in the October Notice of Project Change to follow one of the alternative routes identified in the Environmental Report (June 2020). Note, there are no proposed changes to Phase 3 of the Project. Enbridge Gas has not yet filed a Leave-to-Construct (LTC) application with the OEB.

Dillon has prepared an Environmental Report Amendment in consideration of Enbridge Gas' proposed changes to the preferred route in Phase 4 of the Project. The new preferred route follows one of the alternative routes presented in the Environmental Report (June 2020) and is shown on the attached figure. Phase 3 is not depicted, since there are no changes to Phase 3 routing as presented in the Environmental Report (June 2020).

The objective of the Environmental Report Amendment is to determine if there are any potential environmental or socio-economic impacts as a result of the change in the preferred route that were not captured in the assessment already completed in the Environmental Report (June 2020).

177 Colonnade Road  
Suite 101  
Ottawa, Ontario  
Canada  
K2E 7J4  
Telephone  
613.745.2213  
Fax  
613.745.3491



The Environmental Report (June 2020) and the Environmental Report Amendment are available for review on the Enbridge Gas Project website at <https://www.enbridgegas.com/about-us>. Click on the "Projects" tab and select "St. Laurent Ottawa North Pipeline Project".

Following a review period, the Environmental Report (June 2020) and Environmental Report Amendment will be submitted as part of the LTC application to the OEB. The OEB's review and approval is required before the Project can proceed. If approved, construction of Phase 3 of the Project is anticipated to begin in 2021 and construction of Phase 4 of the Project is anticipated to begin in 2022.

Stakeholder engagement and Indigenous consultation continue to be key components of the Project. We are interested in hearing from you regarding issues/concerns that you may have in relation to the proposed changes to this Project. Please provide feedback to the Project email at [StLaurentNorthEA@dillon.ca](mailto:StLaurentNorthEA@dillon.ca) or by contacting one of the individuals listed below by December 17, 2020.

Tanya Turk  
Environmental Advisor  
Enbridge Gas Inc.  
101 Honda Boulevard,  
Markham, ON L6C 0M6  
(416) 495-3103  
[Tanya.Turk@enbridge.com](mailto:Tanya.Turk@enbridge.com)


Tristan Lefler  
Environmental Assessment Project Manager  
Dillon Consulting Limited  
51 Breithaupt Street, Suite 200  
Kitchener, ON N2H 5G5  
(519) 588-1930  
[StLaurentNorthEA@dillon.ca](mailto:StLaurentNorthEA@dillon.ca)

Sincerely,

DILLON CONSULTING LIMITED

Tristan Lefler, M.Sc.

Attachment: Figure 1: New Phase 4 Preferred Route

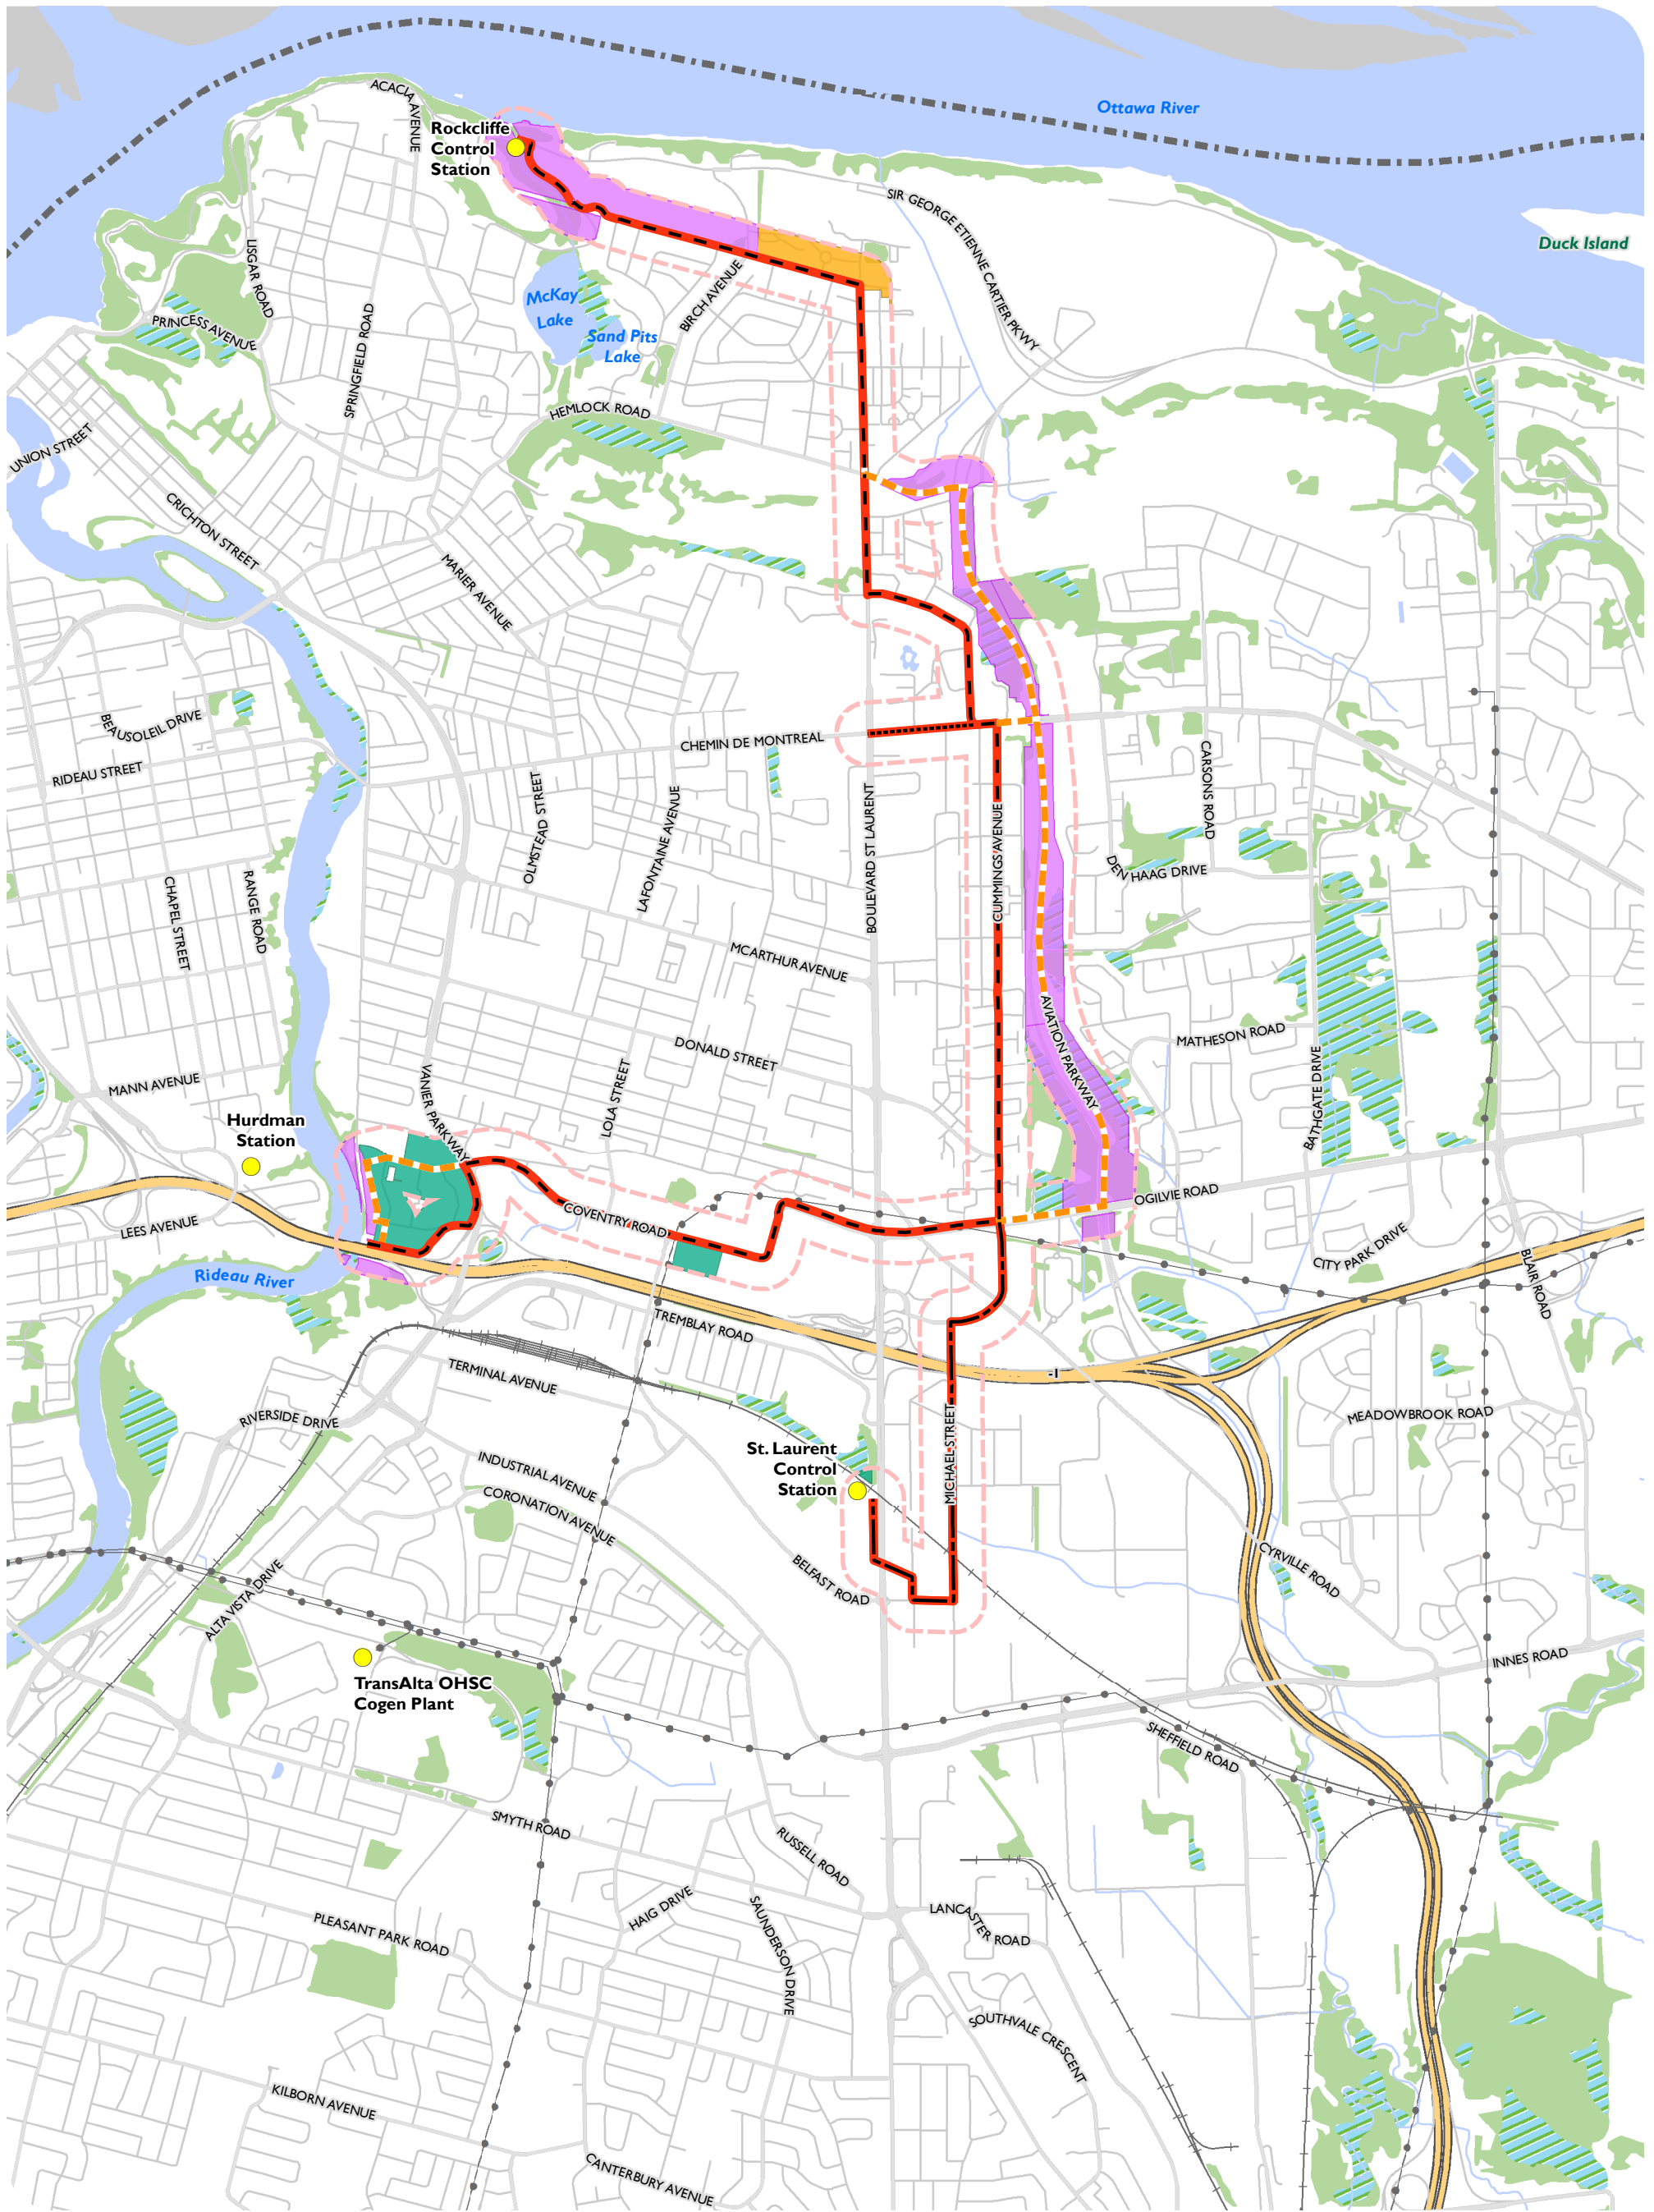

**ENBRIDGE GAS INC.**  
ST. LAURENT OTTAWA NORTH  
REPLACEMENT PIPELINE PROJECT

**NEW PHASE 4  
PREFERRED ROUTE**  
FIGURE I



Existing Station

Alternative Route  
Phase 4 Preferred Route

**Gas Line Types**

NPS 6 XHP Gas Main  
NPS 12 XHP Gas Main  
NPS 16 XHP Gas Main

**Federal Land Ownership (DFRP)**

National Capital Commission  
Public Services and Procurement Canada  
Royal Canadian Mounted Police

**Base Data**

Freeway  
Major Road  
Local Road  
Railway  
Hydro Line


Watercourse

Waterbody  
Provincial Boundary  
Unevaluated Wetland  
Wooded Area



MAP DRAWING INFORMATION:  
DATA PROVIDED BY MNRF,  
ENBRIDGE GAS INC., DFRP  
MAP CREATED BY: GAM  
MAP CHECKED BY: AL  
MAP PROJECTION: NAD 1983 UTM Zone 18N

SCALE 1:25,000

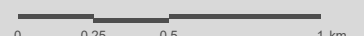

PROJECT: 19-1850 STATUS: DRAFT DATE: 2020-11-11